

**REGISTERED SURVEYOR'S CERTIFICATION**

I, **LANDPARTNERS PTY LTD**, hereby certify that the vertical and horizontal locations and dimensions shown on this plan are a true and correct record and were located by survey.

*[Signature]*  
Registered Surveyor (sig) Reg. Surveyor No. **S4118** Date **9/04/2024**


**AS CONSTRUCTED CERTIFICATION**

I, \_\_\_\_\_ (Company's representative Name) \_\_\_\_\_ (Signature)  
\_\_\_\_\_, (Date) \_\_\_\_\_ (RPEQ)  
Being a duly representative of: \_\_\_\_\_ (Company Name)

Hereby certify that

- The information contained in this drawing / document is in compliance with approved drawings and design supplied under the terms of the contract.
- This represents an accurate "As constructed" record of works carried out and accept responsibility for the information contained in this drawing / document.

**COORDINATE DATUM NOTE:**  
HORIZONTAL COORDINATES (E,N) SUPPLIED ARE MAPPING GRID OF AUSTRALIA (MGA), ZONE 56 BASED ON THE UNIVERSAL TRANSVERSE MERCATOR PROJECTION AND THE GEOCENTRIC DATUM OF AUSTRALIA 2020.

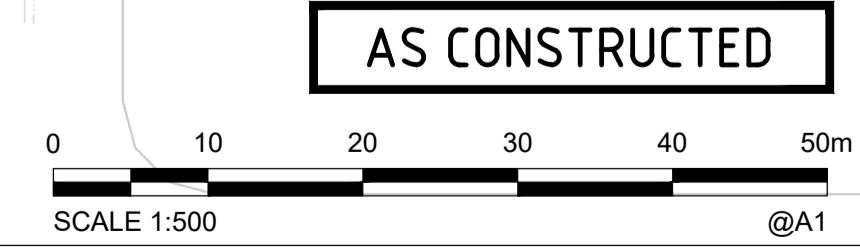

<b>A1</b>	1	9/04/2024	INITIAL ISSUE			
	INDEX	DATE	REVISIONS	DRAWN	CHECKED	PASSED

DRAWN	MJK	9/04/2024
CHECKED	LS	9/04/2024
PASSED	LS	9/04/2024
INITIALS	DATE	

**LANDPARTNERS**  
surveyors and planners

Brisbane Office  
Level 11  
18 Little Cribb Street  
Milton QLD 4064

PO Box 1399  
Milton  
QLD 4064

☎ (07) 3842 1000  
✉ info@landpartners.com.au  
www.landpartners.com.au



**IPSWICH CITY COUNCIL**

MONTVIEW ESTATE STAGE 1 AND 1A  
AS-CONSTRUCTED STORMWATER

SCALE 1500 @A1  
SHEET 1 OF 1 SHEETS  
DRAWING NO.  
BRSS7277-AP1-150-1