


LEGEND

	BOTTOM OF WALL
	TOP OF WALL
	LIP OF KERB
	BACK OF KERB
	EDGE OF CONCRETE
	EDGE OF ROCK
	CONTOURS
	CHANGE OF GRADE
	CROWN OF ROAD



JOINS TO 'A'

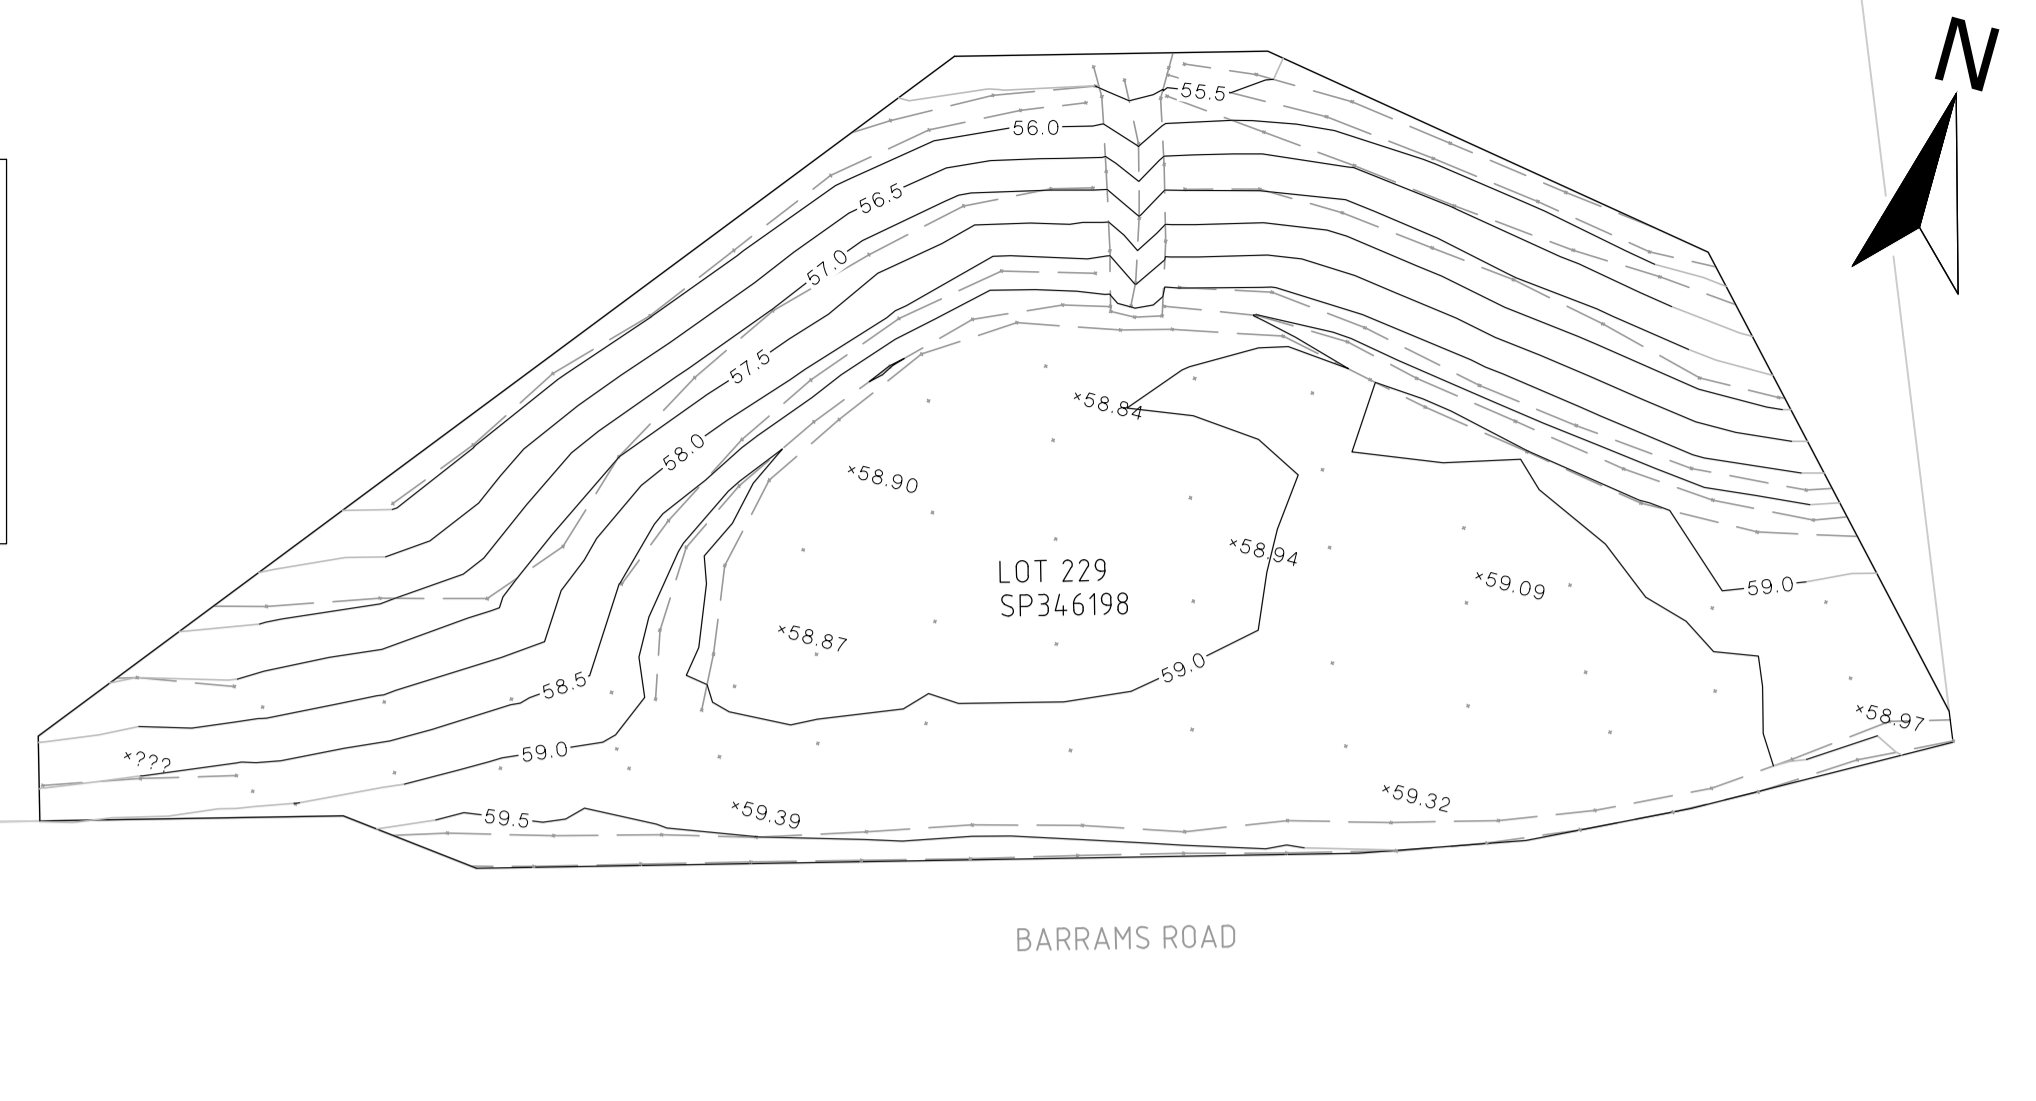


STAGE 5 INSET

REGISTERED SURVEYOR'S CERTIFICATION
 I, LANDPARTNERS PTY LTD, hereby certify that the vertical and horizontal locations and dimensions shown on this plan are a true and correct record and were located by survey.
 Registered Surveyor (sig) Reg. Surveyor No. **S4118** Date: **9/04/2024**

AS CONSTRUCTED CERTIFICATION
 I, _____ (Company's representative Name) _____ (Signature)
 _____ (Date) _____ (RPEQ)
 Being a duly representative of - _____ (Company Name)
 Hereby certify that
 1. The information contained in this drawing / document is in compliance with approved drawings and design supplied under the terms of the contract.
 2. This represents an accurate "As constructed" record of works carried out and accept responsibility for the information contained in this drawing / document.

JOINS TO 'A'

COORDINATE DATUM NOTE:
 HORIZONTAL COORDINATES (E,N) SUPPLIED ARE MAPPING GRID OF AUSTRALIA (MGA), ZONE 56 BASED ON THE UNIVERSAL TRANSVERSE MERCATOR PROJECTION AND THE GEOCENTRIC DATUM OF AUSTRALIA 2020.

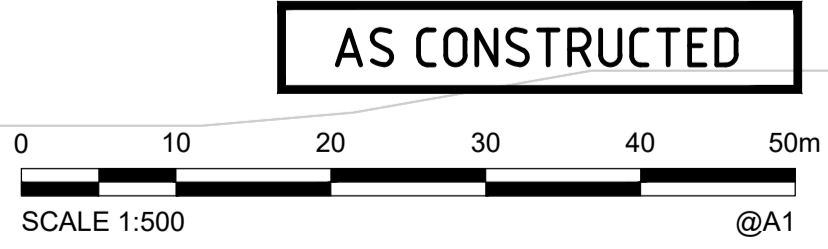

A1	1	9/04/2024	INITIAL ISSUE	MJK	LS	LS
	INDEX	DATE	REVISIONS	DRAWN	CHECKED	PASSED

DRAWN	MJK	9/04/2024
CHECKED	LS	9/04/2024
PASSED	LS	9/04/2024
INITIALS	DATE	

LANDPARTNERS
 Surveyors and Planners
 Brisbane Office
 Level 1
 18 Little Cribb Street
 Milton QLD 4064
 PO Box 1399
 Milton
 QLD 4064
 P: (07) 3842 1000
 F: (07) 3842 1001
 E: info@landpartners.com.au
 W: www.landpartners.com.au

City of Ipswich

IPSWICH CITY COUNCIL
 MONTVIEW ESTATE STAGE 1 AND 1A
 AS-CONSTRUCTED TOPOGRAPHY

SCALE	1500 @ A1
SHEET	1 OF 1 SHEETS
DRAWING NO.	BRSS7277-AP1-151-1